



As Constructed Assets

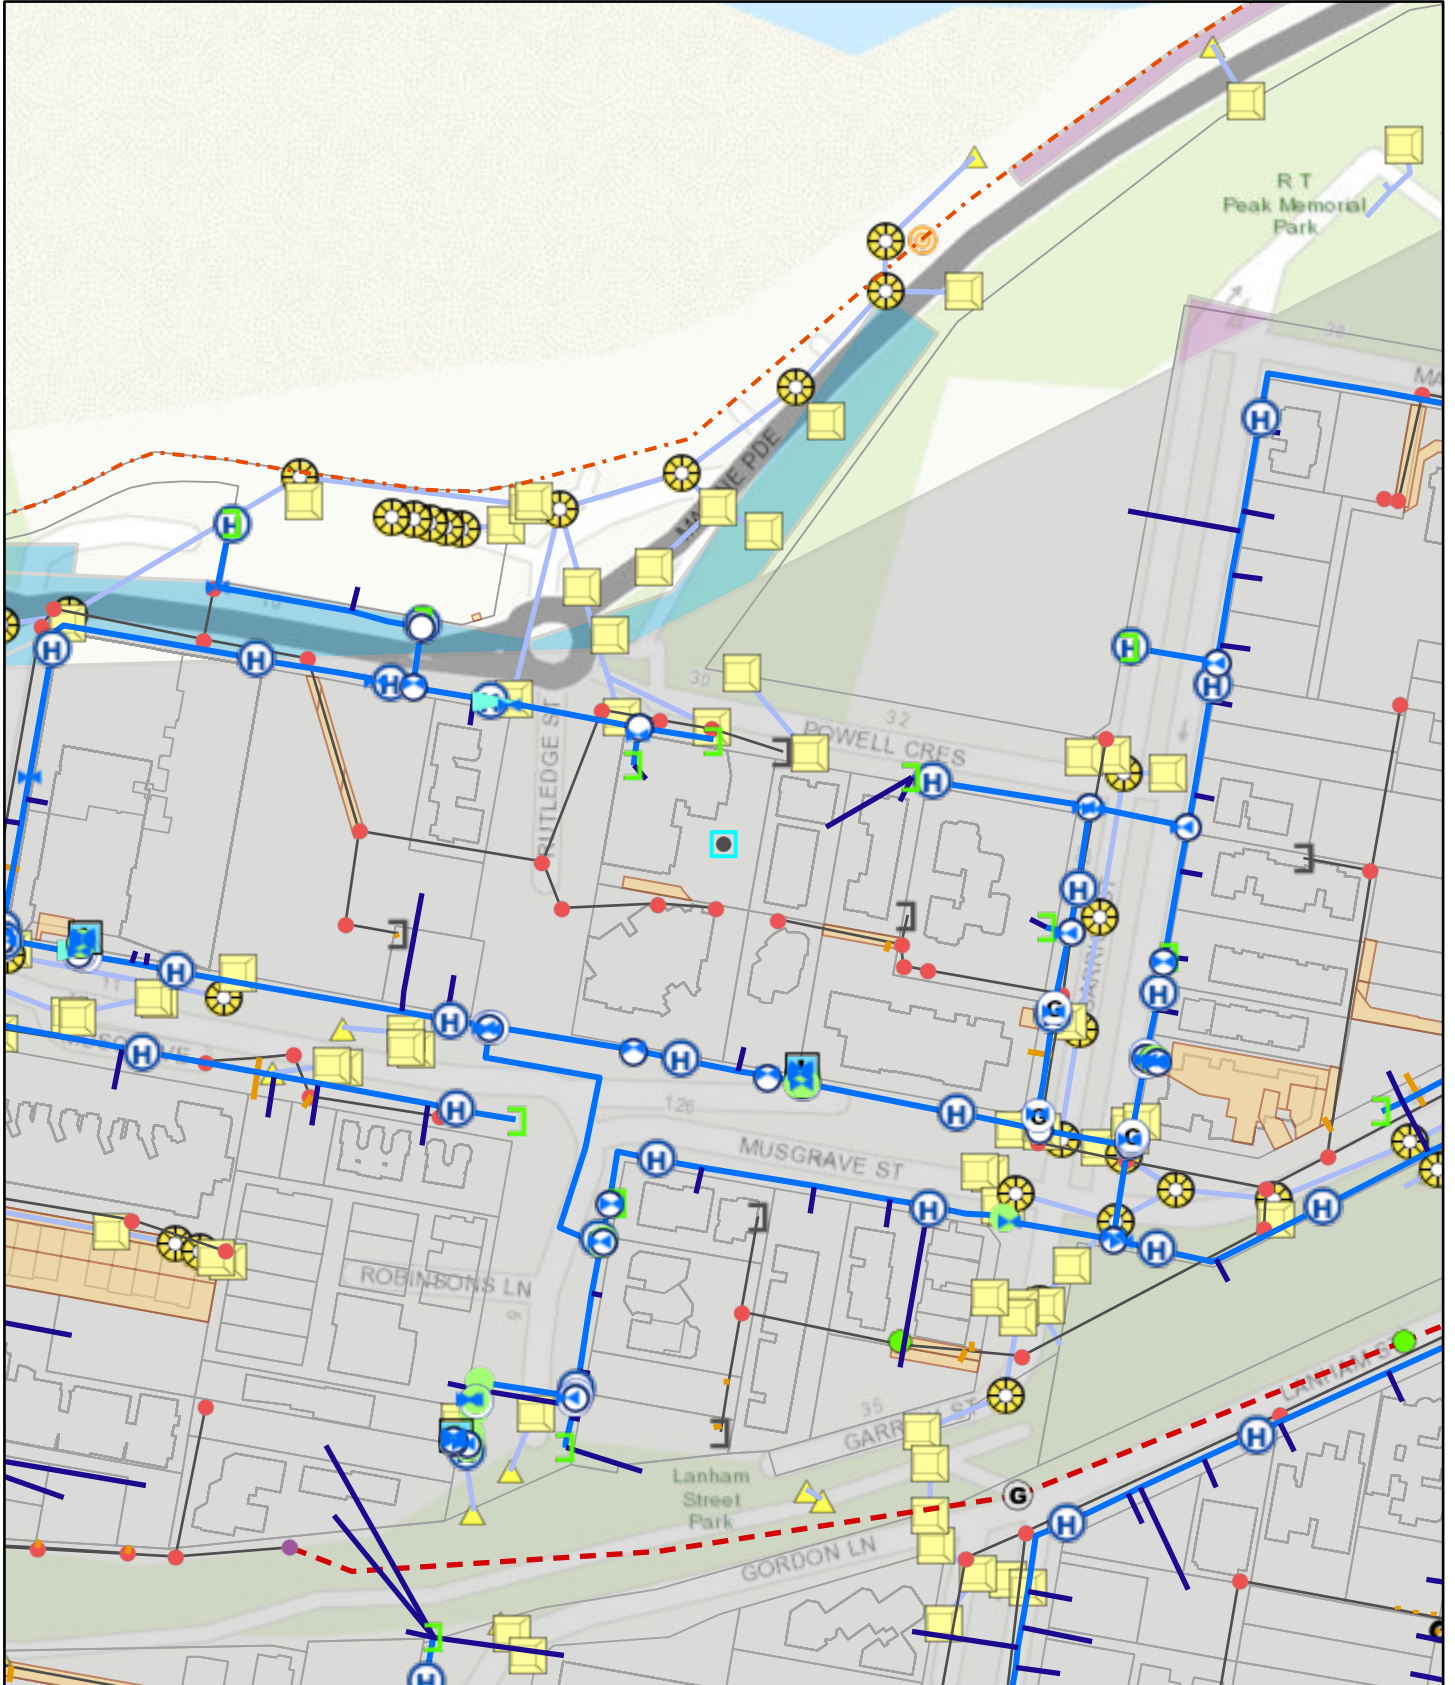

3/20/2026, 11:13:03 AM

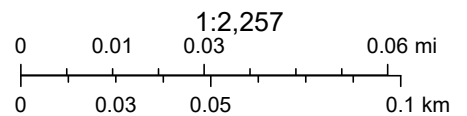

- | | | | |
|--|---|--|---|
| <ul style="list-style-type: none"> Capital_Works 2016-17 2017-18 2018-19 2020-21 2024-25 Other LGA_Boundary Water Valve Water Fitting End Water Service Connection Potable Potable Water Pipe | <ul style="list-style-type: none"> Gibault Sampling Point T - Joint Taper Other Water Hydrant Potable Water Service Connection Potable Potable Water Pipe | <ul style="list-style-type: none"> Sewer Fitting End Cap Junction Other Sewer Valves Gas Release Sewer Connection Sewer Maintenance Hole Maintenance Hole Rising Main Discharge MH Access Pit for a Sewer Valve Sewer Pipe Pressure Rising or Pressure Main | <ul style="list-style-type: none"> Sewer_Pipe_Non_Pressure Drainage Pit Inlet Gully Manhole Drainage Pipe Stormwater Monitoring Station Stormwater End Structure Easement Cadastre |
|--|---|--|---|

NPSR, Esri, © OpenStreetMap contributors, HERE, Garmin, USGS

City of Gold Coast

This information is provided to assist in field investigations. Spot checks have been made to determine the accuracy of this plan. However, all locations, dimensions and depths shown are to be