



# As Constructed Assets

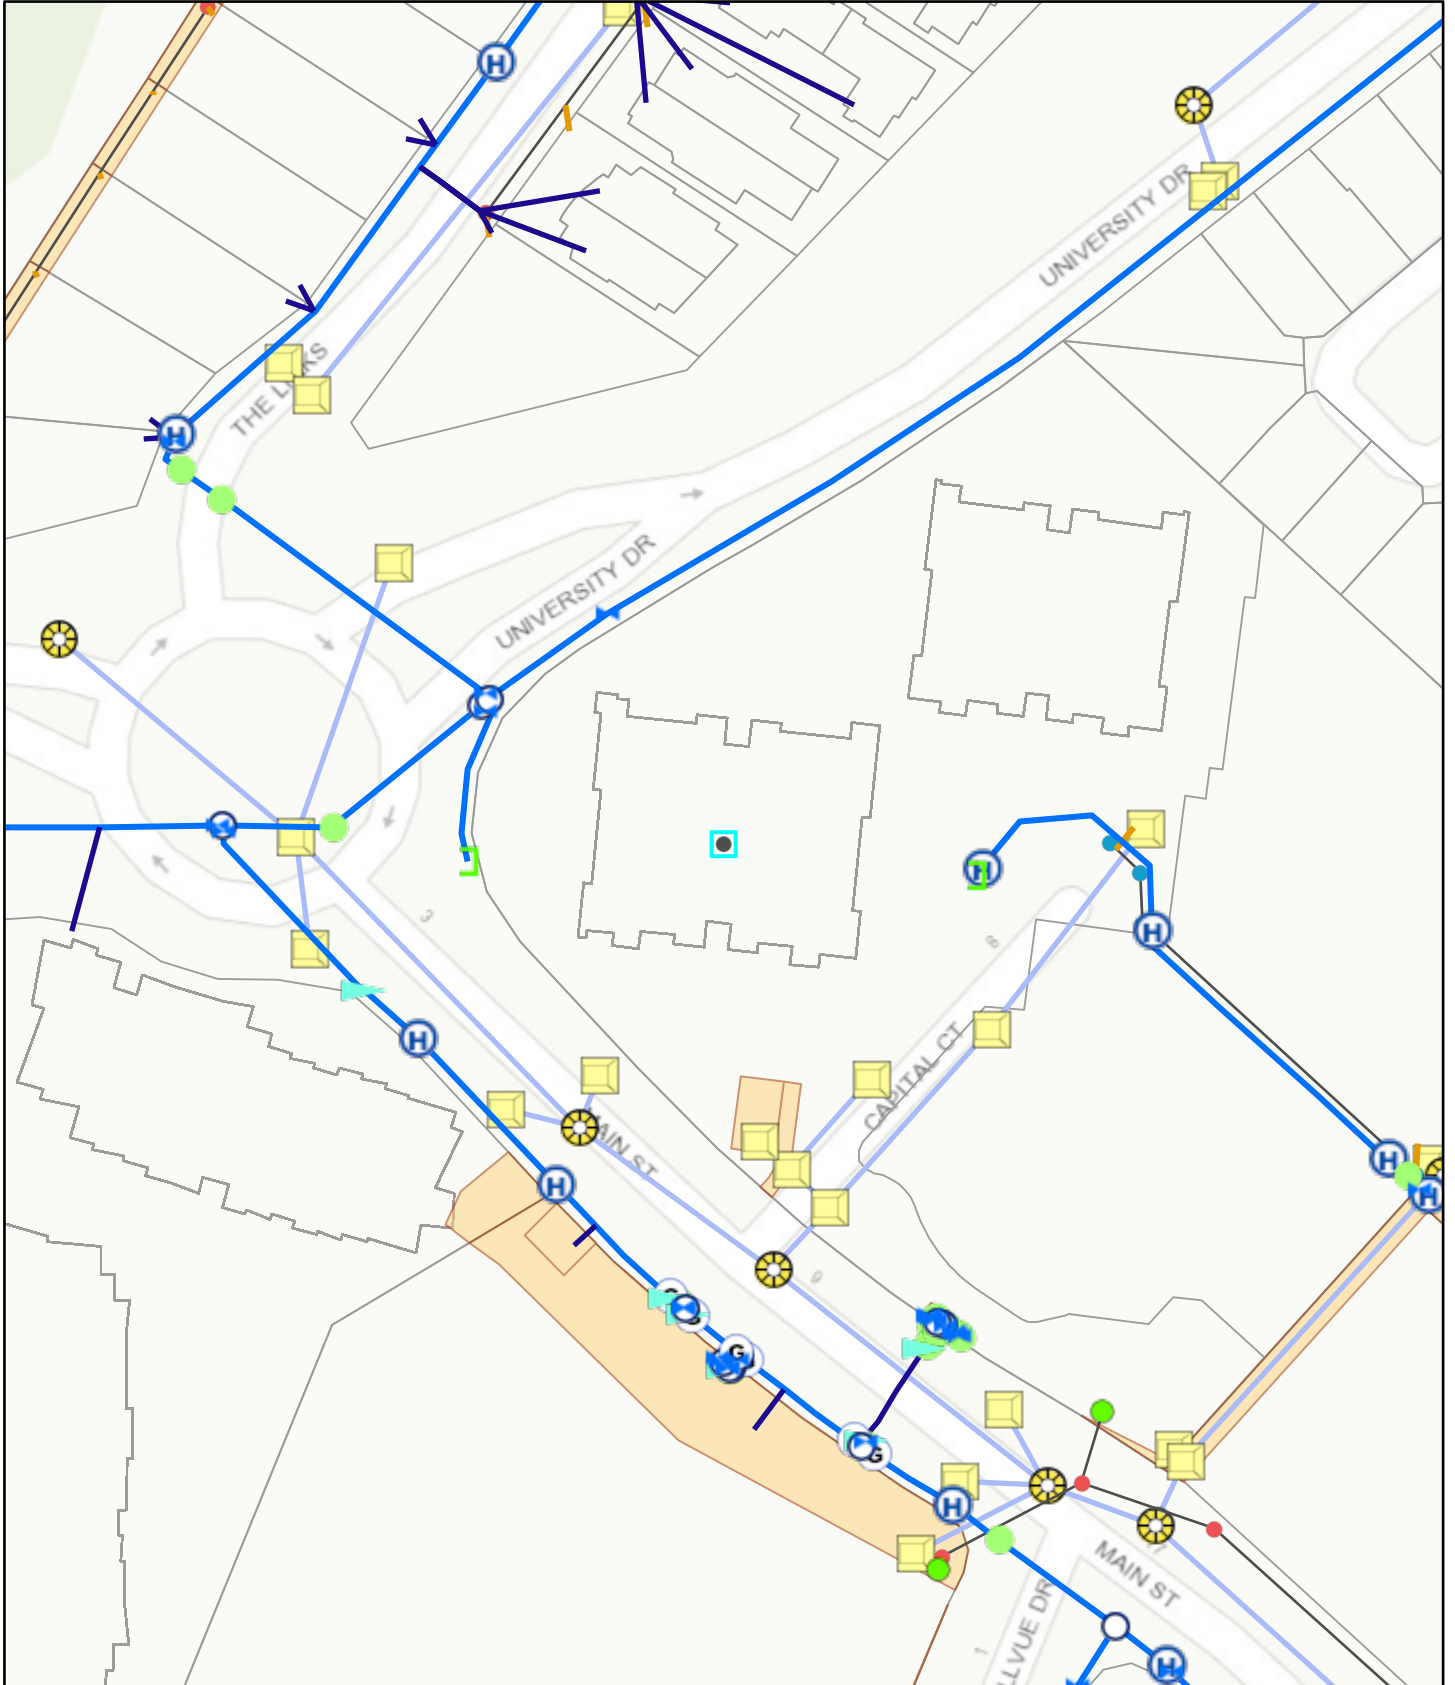

4/9/2026, 10:12:01 AM

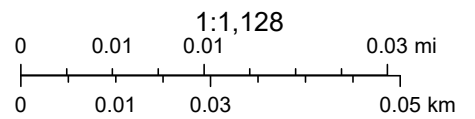

- |                                  |                        |                         |
|----------------------------------|------------------------|-------------------------|
| LGA_Boundary                     | Water Hydrant Potable  | Maintenance Shaft       |
| Water Valve                      | Water Maintenance Hole | Sewer_Pipe_Non_Pressure |
| Water Fitting                    | Gibault                | Drainage Pit            |
| End                              | T - Joint              | Inlet Gully             |
| Gibault                          | Other                  | Manhole                 |
| T - Joint                        | Maintenance Hole       | Drainage Pipe           |
| Taper                            | Sewer Connection       | Easement                |
| Other                            | Maintenance Hole       | Cadastre                |
| Water Service Connection Potable |                        |                         |
| Potable Water Pipe               |                        |                         |

NPSR, Esri, © OpenStreetMap contributors, HERE, Garmin, USGS

City of Gold Coast

This information is provided to assist in field investigations. Spot checks have been made to determine the accuracy of this plan. However, all locations, dimensions and depths shown are to be